
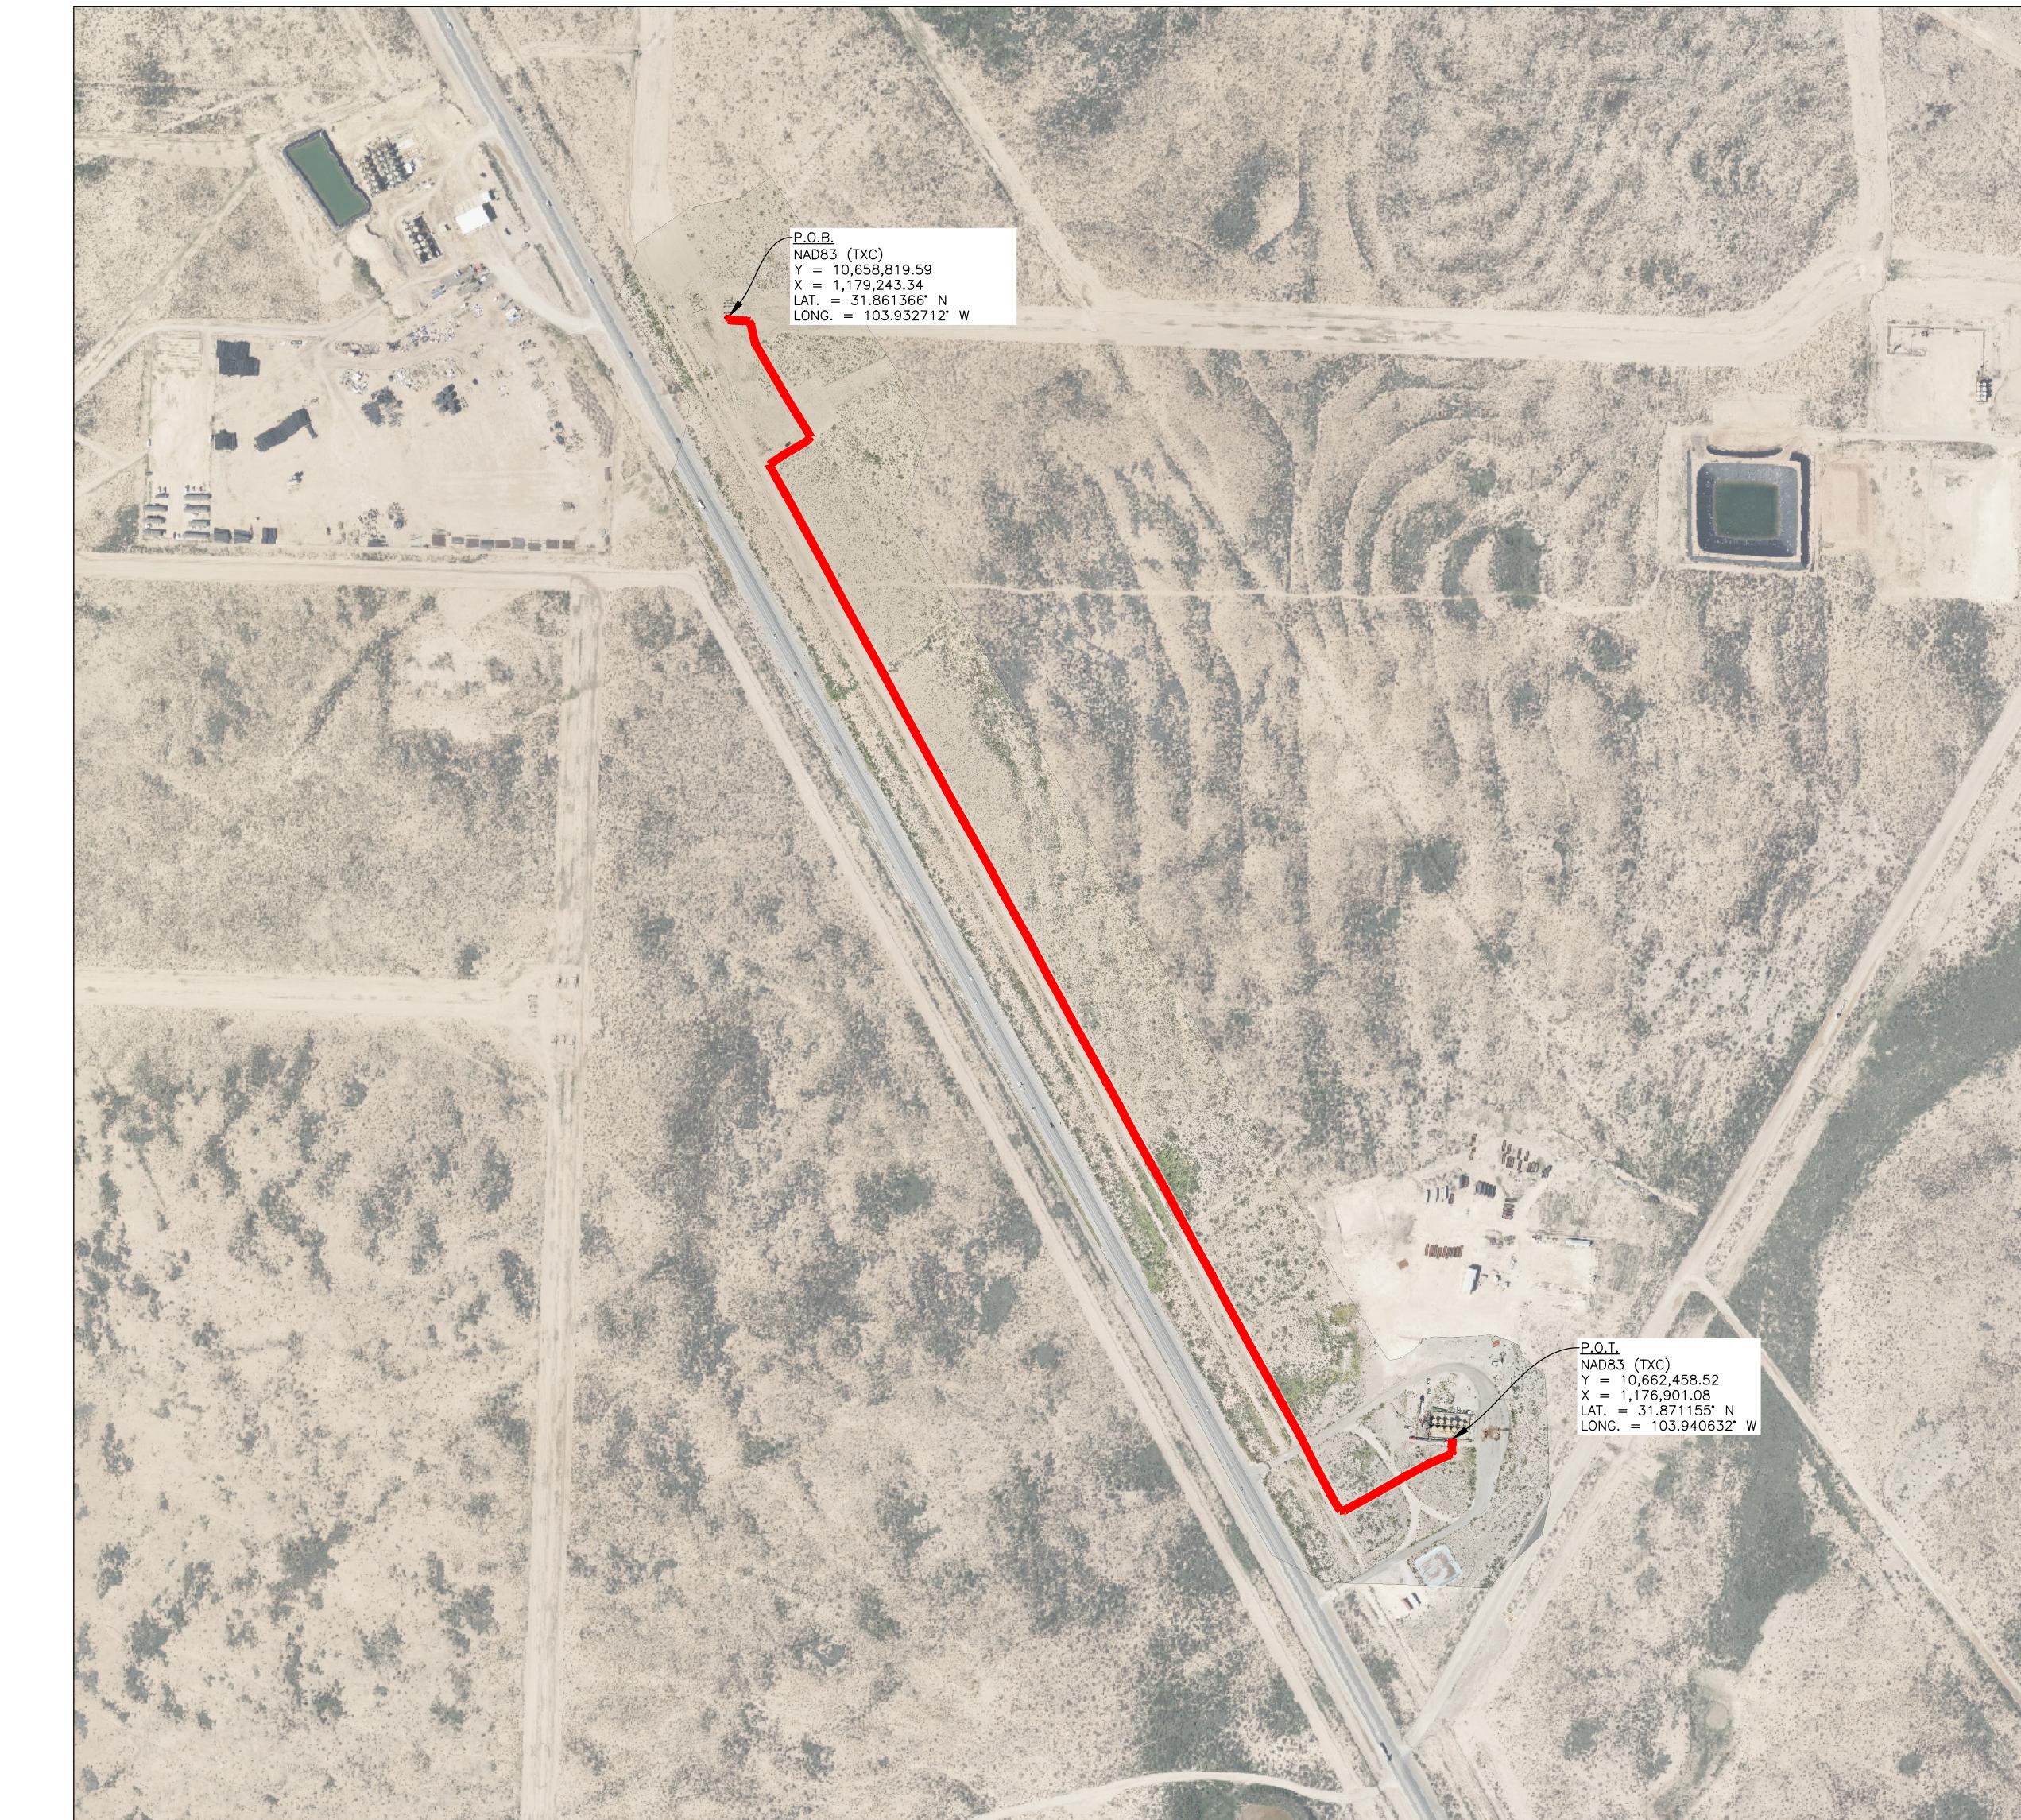


# **SELECT WATER SOLUTIONS**

## **AN AS-BUILT PIPELINE FOR ORLA KESSLER WES**

### **REEVES COUNTY, TEXAS**

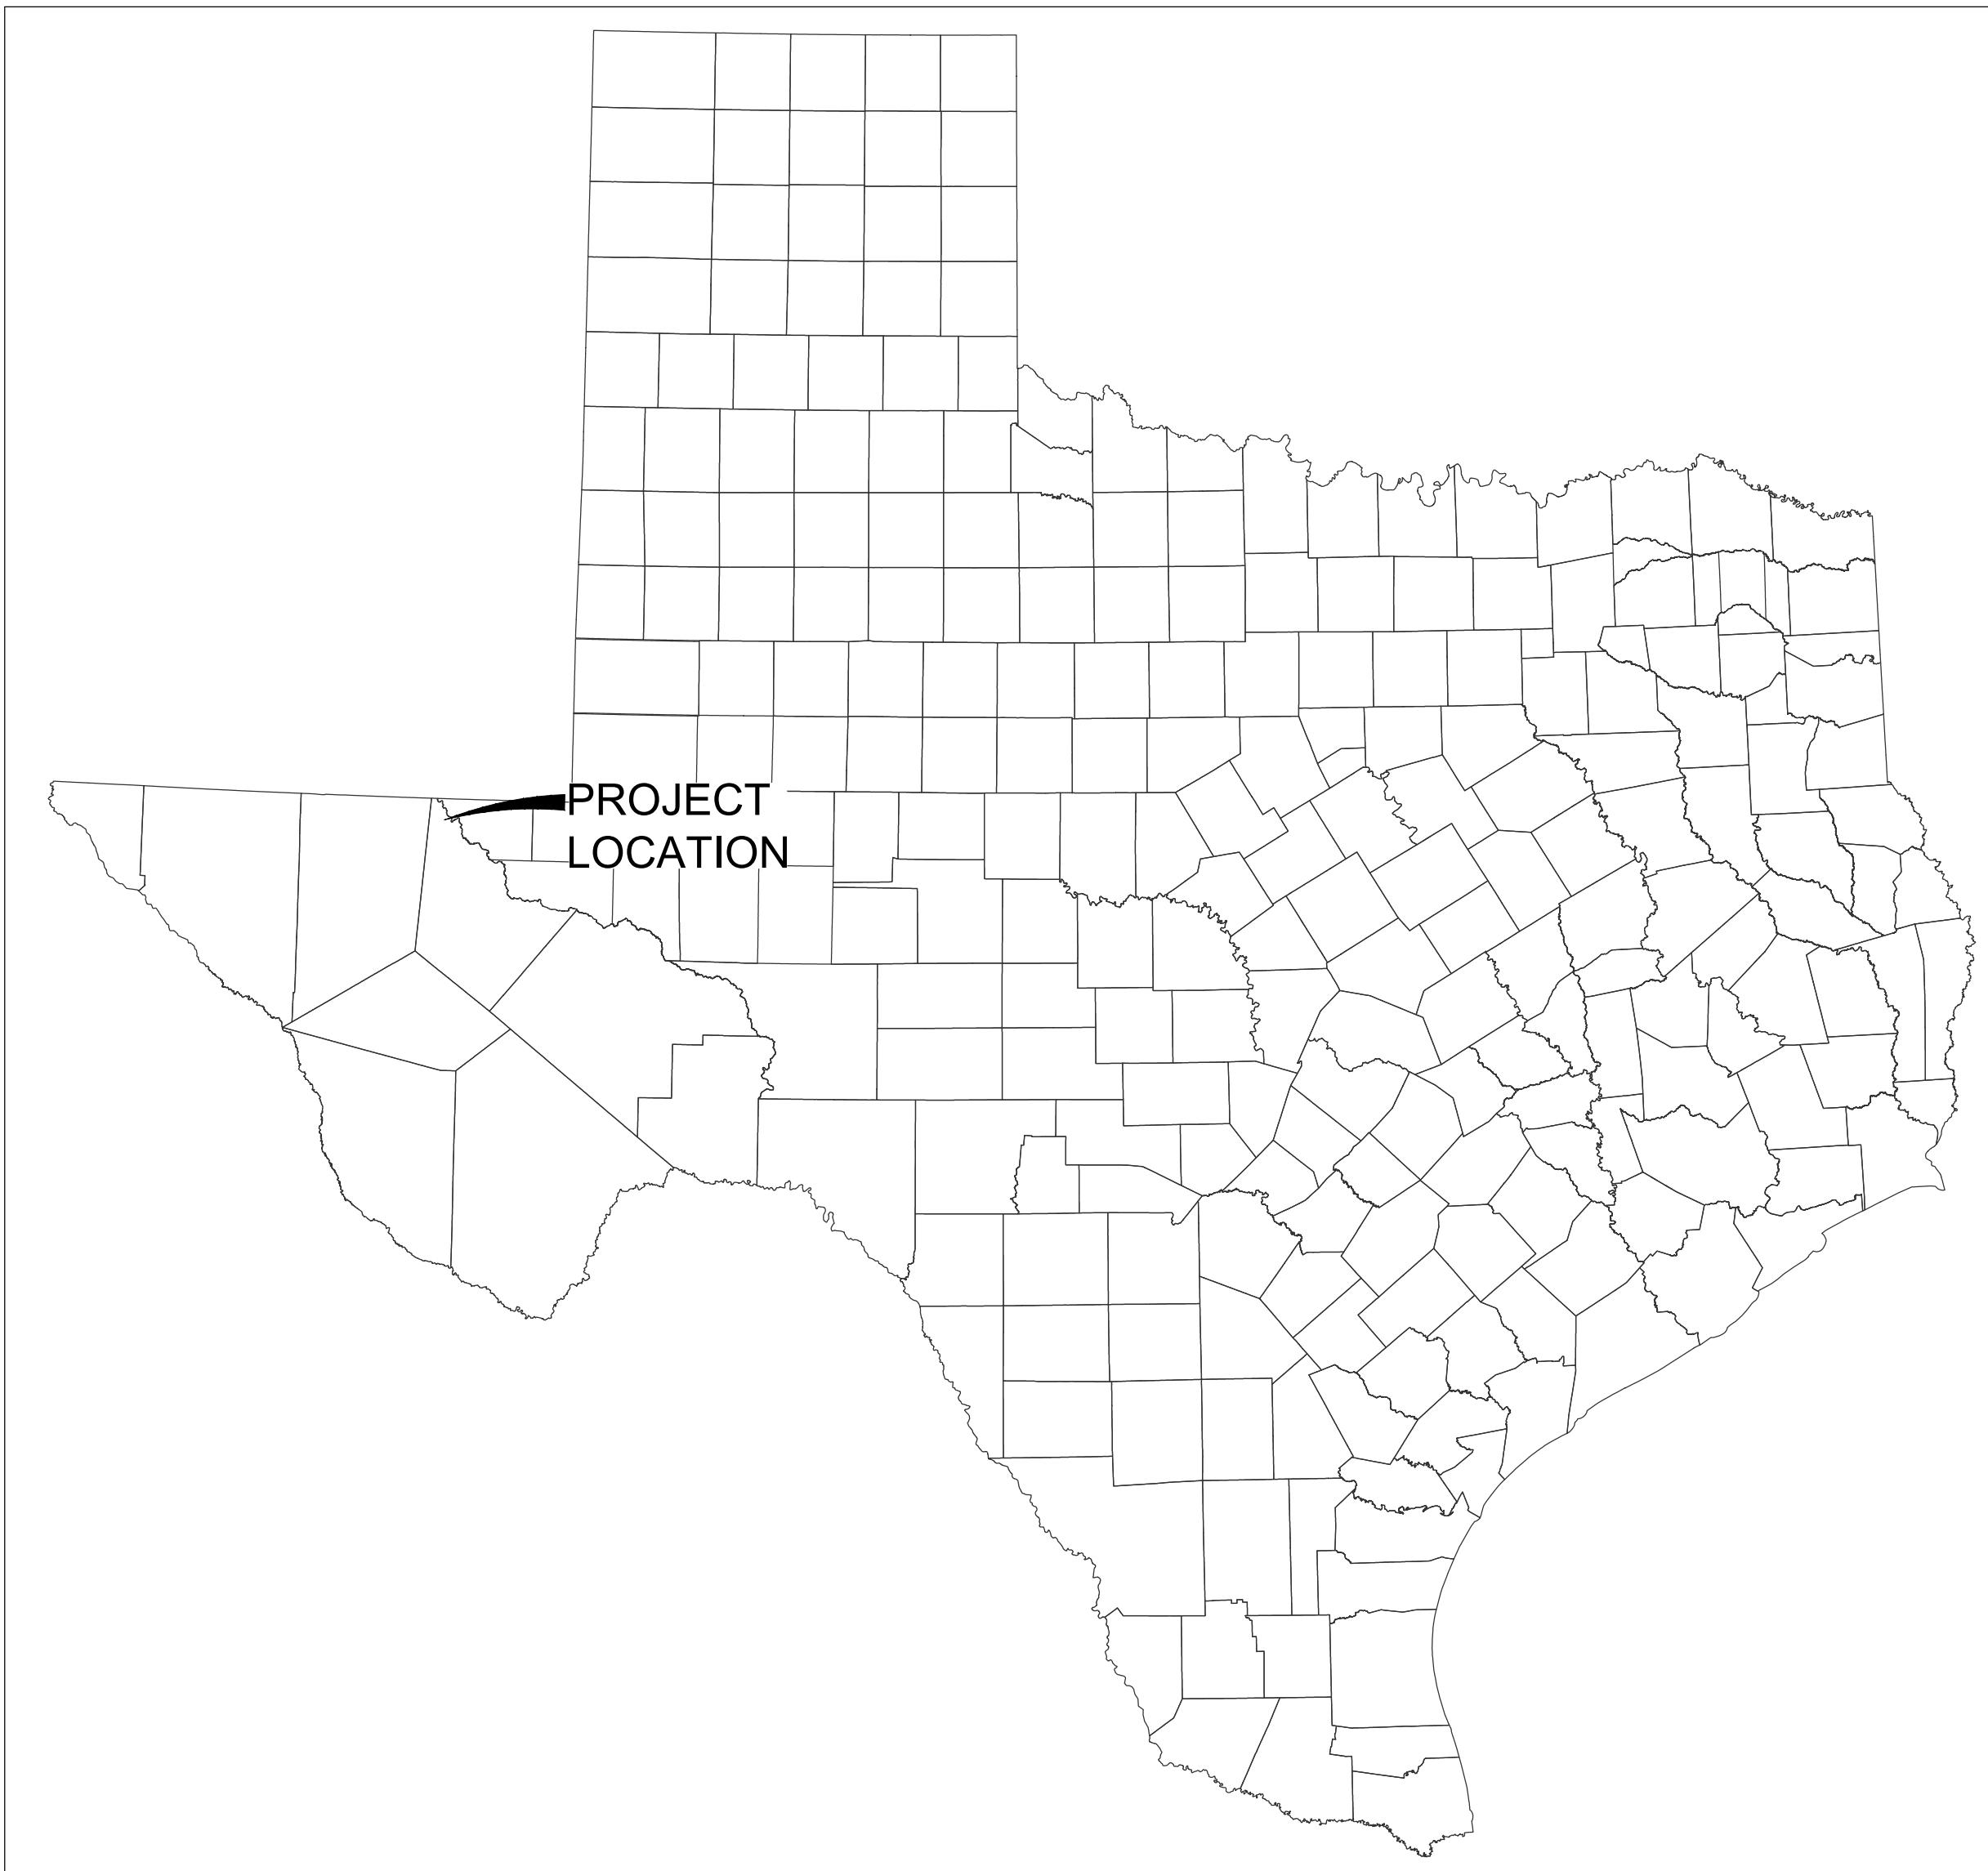

N

# AS-BUILT

- | DRAWN BY | GENERAL NOTES   |
|----------|---|
|          | <ol style="list-style-type: none"><li>1. ALL BEARINGS AND DISTANCES REFER TO THE TEXAS STATE PLANE COORDINATE SYSTEM OF NAD 1983 (HARN), CENTRAL ZONE 4203. AREA, DISTANCES, AND COORDINATES ARE "GRID" VALUES.</li><li>2. AREA, DISTANCE, AND COORDINATES ARE "GRID."</li><li>3. UNITS ARE UNITED STATES SURVEY FOOT.</li><li>4. VERTICAL DATUM IN NAVD 88</li><li>5. ALL TRACT INFORMATION SHOWN HEREON IS DONE SO BY LIMITED DEED RECORD INFORMATION ONLY. ALL ACREAGE SHOWN ARE BY DEED AND LEASE CALL, EXCEPT WHERE NOTED. THIS IS NOT IN ANY WAY A "BOUNDARY SURVEY".</li><li>6. LOCATION OF PIPELINES SHOWN ARE BASED ON THE USE OF SCARS AND PIPELINES SHOWN AND BASED ON THE USE SCARS AND PIPELINE MARKERS. PIPELINES WERE COVERED.</li><li>7. CALL BEFORE YOU DIG – TEXAS811.ORG</li></ol> |



AFE NO.	<u>AFE No.</u>	AS-BUILT PIPELINE FOR ORLA KESSLER WES	
PROJ. MGR.:	<u>JW</u>		
PROJ. NO.	<u>618.013002.00</u>		
DRAWN BY:	<u>JAR</u>	<b>STATION 0+00 - 49+83</b>	
DATE:	<u>09-22-2025</u>	REEVES COUNTY, TEXAS	
CHECKED BY:	<u>LB</u>		
		REV. 0	SHEET 1 OF 3

**STATE** REEVES COUNTY, TEXAS  
TERRAIN GRASS, BRUSH

**OWNER** SELECT WATER SOLUTIONS, LLC  
ALL OF SEC 11 (S&E 43.15 AC. TRACT)  
INST. NO. 2025-4237, O.P.R.R.C.T.

**FEET/RODS** SECTION 11, T. & P. RR. CO. SURVEY, T-2, BLOCK 57, A-1019  
1,430.00 FEET OR 86.67 RODS

**CROSSINGS** SECTION 11, T. & P. RR. CO. SURVEY, T-2, BLOCK 57, A-1019  
1,570.00 FEET OR 95.15 RODS

**PLAN VIEW**

**PROFILE**

SCALE HORIZONTAL 1" = 100'  
SCALE VERTICAL 1" = 10'

**LEGEND**

- SECTION LINE
- EXISTING PIPELINE
- PROPOSED PIPELINE
- PROPOSED BORE
- PROPOSED ADDITIONAL WORKSPACE
- TOE OF BANK
- TOP OF BANK
- BURIED OVERHEAD ELECTRIC
- BURIED ELECTRIC
- EDGE OF PAVEMENT
- EXISTING GUY WIRE
- EXISTING WATERLINE
- EXISTING FENCE
- FIBER OPTIC CABLE
- EDGE OF RIGHT OF WAY
- TV CABLE
- POWER CABLE
- CAVITY CABLE
- EXISTING POWER POLE
- TELEPHONE PEDESTAL
- EXISTING SEWER
- ELECTRIC METER
- WATER METER
- STORM MANHOLE
- TRAFFIC SIGN
- MAIN VALVE
- WATER MAIN VALVE
- BURIED FIBER OPTIC CABLE
- BURIED FIBER OPTIC PEDESTAL
- FIRE HYDRANT
- LIGHT POLE
- MAILBOX
- AIR RELEASE VALVE
- BORE ENTRY/EXIT
- TV CABLE PEDESTAL

**MATERIALS**

ITEM	TOTAL
EXISTING POWER POLE	1
TELEPHONE PEDESTAL	1
EXISTING SEWER	1
ELECTRIC METER	1
WATER METER	1
STORM MANHOLE	1
TRAFFIC SIGN	1
MAIN VALVE	1
WATER MAIN VALVE	1
BURIED FIBER OPTIC CABLE	1

**GENERAL NOTES**

- ALL BEARINGS AND DISTANCES REFER TO THE TEXAS STATE PLANE COORDINATE SYSTEM OF 1983 (HARN), CENTRAL ZONE 4203. AREA, DISTANCES, AND COORDINATES ARE "GRID" VALUES.
- AREA, DISTANCE, AND COORDINATES ARE "GRID."
- UNITS ARE UNITED STATES SURVEY FOOT.
- VERTICAL DATUM IN NAVD 88.
- ALL SURVEY INFORMATION CONTAINED HEREON IS DONE SO BY LIMITED DEED RECORD INFORMATION ONLY. ALL ACREAGE SHOWN ARE BY DEED AND LEASE CALL, EXCEPT WHERE NOTED. THIS IS NOT IN ANY WAY A "BOUNDARY SURVEY".
- LOCATION OF PIPELINES SHOWN ARE BASED ON THE USE OF SCARS AND PIPELINES SHOWN ARE BASED ON THE USE OF SCARS AND PIPELINE MARKERS. PIPELINES WERE COVERED.
- CALL BEFORE YOU DIG - TEXAS811.ORG

**Manhard CONSULTING** TM  
4617 50th Street, Suite 10, Lubbock, TX 79414 ph:806.810.5001 manhard.com  
Civil Engineering | Surveying & Geospatial Services | GIS  
Water Resource Management | Construction Management

**SELECT**

**AS-BUILT PIPELINE FOR**  
**ORLA KESSLER WES**

**STATION 0+00 - 30+00**  
**REEVES COUNTY, TEXAS**

**REV. 0**

**SHT 2 OF 3**

**REEVES COUNTY, TEXAS**

STATE TERRAIN	GRASS, BRUSH		
OWNER	SELECT WATER SOLUTIONS, LLC ALL OF SEC 11 (S&E 43.15 AC. TRACT) INST. NO. 2025-4237, O.P.R.R.C.T.		
FEET/RODS	SECTION 11, T. & P. RR. CO. SURVEY, T-2, BLOCK 57, A-1019 947 FEET OR 57.39 RODS		
CROSSINGS	SECTION 2, T. & P. RR. CO. SURVEY, T-2, BLOCK 57, A-5661 1,036 FEET OR 62.79 RODS		
PLAN VIEW	<p>30+00 MATCHLINE SEE SHEET 2</p> <p>T. &amp; P. RR. CO. SURVEY SECTION 11, BLOCK 57, A-1019 T2</p> <p>33+47 SURVEY SECTION LINE</p> <p>HERD PARTNERS LTD. VOL. 545, PG. 253 O.P.R.R.C.T.</p> <p>P.D.T. NAVD83 (TIC) X = 103.940632 Y = 2853.82 LAT = 31.871155 N LONG = 103.940632 W</p> <p>T. &amp; P. RR. CO. SURVEY SECTION 2, BLOCK 57, A-5661 T2</p> <p>49+83 POINT OF TERMINUS 49+79 EXISTING WESTERN MASTREAM PIPELINE</p>		
PROFILE	<p>SCALE HORIZONTAL 1" = 100' SCALE VERTICAL 1" = 10'</p> <p>2880</p> <p>2860</p> <p>2840</p> <p>2820</p> <p>2800</p> <p>2880</p> <p>2860</p> <p>2840</p> <p>2820</p> <p>2800</p> <p>STA 30+00 STA 31+00 STA 32+00 STA 33+00 STA 34+00 STA 35+00 STA 36+00 STA 37+00 STA 38+00 STA 39+00 STA 40+00 STA 41+00 STA 42+00 STA 43+00 STA 44+00 STA 45+00 STA 46+00 STA 47+00 STA 48+00 STA 49+00 STA 50+00</p> <p>MINIMUM COVER</p> <p>EXISTING WESTERN MASTREAM PIPELINE</p>		
<p><b>LEGEND</b></p> <ul style="list-style-type: none"> <li>PROPERTY LINE</li> <li>EXISTING PIPELINE</li> <li>PROPOSED PIPELINE</li> <li>PROPOSED BORE</li> <li>PROPOSED ADDITIONAL WORKSPACE</li> <li>TOP OF BANK</li> <li>TOP OF DITCH</li> <li>EXISTING OVERHEAD ELECTRIC</li> <li>EXISTING GUY WIRE</li> <li>EXISTING WATERLINE</li> <li>EXISTING FENCE</li> <li>EDGE OF RIGHT OF WAY</li> <li>EDGE OF PAVEMENT</li> <li>EXISTING CABLE</li> <li>BURIED FIBER OPTIC CABLE</li> <li>EXISTING POWER POLE</li> <li>TELEPHONE PEDESTAL</li> <li>SANITARY SEWER</li> <li>FIBER OPTIC CABLE</li> <li>POWER POLE</li> <li>WATER METER</li> <li>STORM MANHOLE</li> <li>TRAFFIC SIGN</li> <li>WATER MAIN VALVE</li> <li>BURIED FIBER OPTIC CABLE</li> <li>FIRE HYDRANT</li> <li>LIGHT POLE</li> <li>WATER METER</li> <li>MAILBOX</li> <li>AIR RELEASE VALVE</li> <li>BORE ENTRY/EXIT</li> <li>TV CABLE PEDESTAL</li> </ul> <p><b>MATERIALS</b></p> <table border="1"> <tr> <td>TOTALS</td> </tr> </table> <p><b>GENERAL NOTES</b></p> <ol style="list-style-type: none"> <li>ALL BEARINGS AND DISTANCES REFER TO THE TEXAS STATE PLANE COORDINATE SYSTEM OF NAV 1983 (HARN), CENTRAL ZONE #203. AREA, DISTANCES, AND COORDINATES ARE "GRID" VALUES.</li> <li>AREAS, DISTANCE, AND COORDINATES ARE "GRID."</li> <li>UNITS ARE UNITED STATES SURVEY FOOT.</li> <li>VERTICAL DATUM IS NAVD 88.</li> <li>ALL INFORMATION SHOWN HEREON IS DONE SO BY LIMITED DEED RECORD INFORMATION ONLY. ALL AGREEMENTS SHOWN ARE BY DEED AND LEASE CALL, EXCEPT WHERE NOTED. THIS IS NOT IN ANY WAY A "BOUNDARY SURVEY".</li> <li>LOCATION OF PIPELINES SHOWN ARE BASED ON THE USE OF SCARS AND PIPELINE MARKERS. PIPELINES WERE COVERED.</li> <li>CALL BEFORE YOU DIG - TEXAS811.ORG</li> </ol>			TOTALS
TOTALS			
<p><b>Manhard</b> CONSULTING™</p> <p><b>SELECT</b></p> <p>4617 50th Street, Suite 10, Lubbock, TX 79414 ph:806.810.5001 manhard.com Civil Engineering   Surveying &amp; Geospatial Services   GIS Water Resource Management   Construction Management</p> <p>AS-BUILT PIPELINE FOR ORLA KESSLER WES</p> <p>STATION 30+00 - 49+83 REEVES COUNTY, TEXAS</p> <p>REV. 0</p> <p>SHT 3 OF 3</p>			